

SANITARY SEWER IMPROVEMENTS FOR TAPADERO WASTEWATER IMPROVEMENT DISTRICT ON PRESCOTT COUNTRY CLUB BLVD

PREPARED FOR
TOWN OF PRESCOTT VALLEY


LOCATED IN A PORTION OF SECTION 28, TOWNSHIP 14 NORTH, RANGE 1 EAST,
OF THE GILA & SALT RIVER MERIDIAN, YAVAPAI COUNTY, ARIZONA

| EXST | NEW | ABBREV | UTILITIES |
|------|-----|--------|---|
| | | MH | Sewer Manhole, MAG Std Detail 420 |
| | | FH | Fire Hydrant, YAG Std Detail 3-07 |
| | | WM | Water Meter, PV Std Detail |
| | | WV | Water Valve Box And Riser, MAG Std Detail 391 |
| | | ARV | Air Release Valve, PV Std Detail |
| | | BO | Blowoff, MAG Std Detail 390 |
| | | PP | Power Pole |
| | | XFMR | Pad Mounted Transformer |
| | | JBOX | Junction Box |
| | | SC | Switching Cabinet |
| | | M | Meter |
| | | TM | Telephone Manhole |


| SURVEY | |
|--------|--|
| | Survey Monument, MAG Std Detail 120-1 Type A |
| | Survey Monument, Pk & Shiner |
| | Control Point |
| | Spot Elevation |
| | Pot Hole Location |

| ABBREVIATIONS | | | |
|---------------|---------------------------|------|---|
| STD | Standard | PVI | Point Of Vertical Intersection |
| TYP | Typical | VC | Vertical Curve |
| RW | Right Of Way | STA | Station |
| PL | Property Line | ELEV | Elevation |
| ESMT | Easement | PUE | Public Utility Easement |
| CL | Centerline | YAG | Central Yavapai County Governments Unified Construction Standards |
| FL | Flowline | MAG | Maricopa Association Of Governments |
| CMP | Corrugated Metal Pipe | | |
| DIP | Ductile Iron Pipe | | |
| PVC | Polyvinyl Chloride | | |
| HDPE | High Density Polyethylene | | |

| EXST | NEW | LINETYPE |
|------|-----|----------------------|
| | | Water Line |
| | | Sewer Line |
| | | Sewer Force Main |
| | | Gas Line |
| | | Overhead Power |
| | | Electric Line |
| | | Telco Line |
| | | Cable Television |
| | | Fence |
| | | Storm Drain Pipe |
| | | Roadway Centerline |
| | | Right Of Way |
| | | Property Line |
| | | Easement |
| | | Index Contour |
| | | Intermediate Contour |

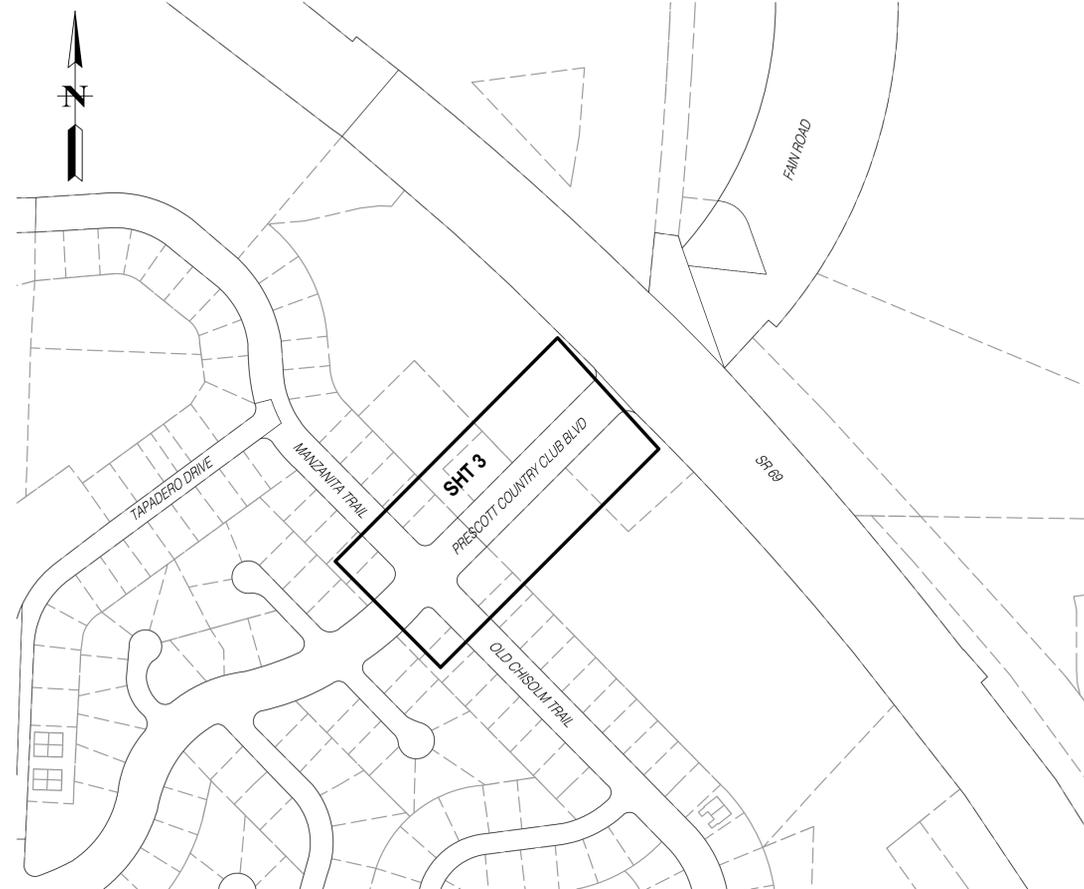

SITE MAP
1"=200'

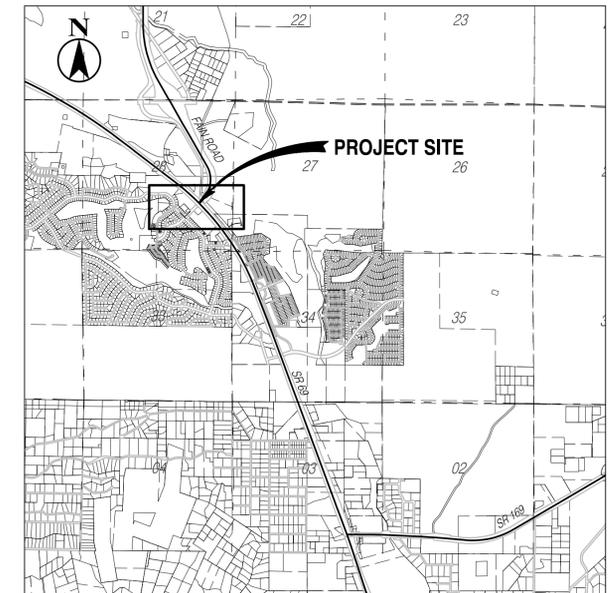

VICINITY MAP
1"=3000'

| SHEET INDEX | |
|-------------|----------------------|
| SHEET | TITLE |
| 1 | COVER |
| 2 | NOTES & DETAILS |
| 3 | PLAN & PROFILE SHEET |

TOWN OF PRESCOTT VALLEY APPROVAL

BY: _____ DATE: _____

RECORD DRAWING CERTIFICATION

With the addition of my signature below I certify that this project has been completed in substantial conformance with the construction plans and referenced standards and specifications and that these Record Construction Documents reflect only the position of facilities constructed in accordance with these plans based upon field measurements and construction reports. Users of Record Documents are advised to obtain independent verification of actual conditions.

Signature _____

Registered Professional Engineer State of Arizona No. _____

OWNER INFORMATION

Tapadero Domestic Wastewater Improvement District
Administered By: Improvement District Services
1965 Commerce Center Circle, Suite A
Prescott, AZ 86301
(928) 443-9484

LOCAL BENCHMARK

SURVEY DATUM IS TOWN OF PRESCOTT VALLEY
BASED ON 2008 MAPPING
ALL VALUES ARE GROUND VALUES
HORIZONTAL DATUM IS NAD 83
VERTICAL DATUM IS NAVD 88

UTILITY CONTACT INFORMATION

UNISOURCE
6405 Wilkinson Dr.
Prescott, AZ 86301
phone: 928-771-7229
contact: Sara Miller

CABLE ONE
3201 Tower Rd.
Prescott, AZ 86301
phone: 928-443-3348
contact: Johnny Cedillo

TOWN OF PRESCOTT VALLEY PUBLIC WORKS
7501 E. Civic Circle
Prescott Valley, AZ 86314
phone: 928-759-3075
fax: 928-759-5514
contact: Ray Smith

ARIZONA PUBLIC SERVICE
120 N. Marina St.
Prescott, AZ 86301
phone: 928-776-3696
contact: Connie Harbin

QWEST
1445 Masonry Way
Prescott, AZ 86301
phone: 928-776-2510
contact: Karen Porter

WATER & SEWER TOWN OF PRESCOTT VALLEY UTILITY DEPARTMENT
7501 E. Civic Circle
Prescott Valley, AZ 86314
phone: 928-759-3070
fax: 928-759-5514
contact: Neil Wadsworth

Contract Operations
TOWN OF PRESCOTT VALLEY
phone: 928-759-9062



DAYA & ASSOCIATES, INC.
310 E. UNION STREET
PRESCOTT, AZ 86303
(928) 776-1111
www.DayaCA.com

PLANNING
ENGINEERING
SURVEYING

CHECKED BY: GMB
DESIGNED BY: GHH



| NO. | DATE | REVISIONS | APPRV. |
|-----|------|-----------|--------|
| | | | |

PROJECT NO. **374sctd3**
DATE **July 2013**

SANITARY SEWER IMPROVEMENTS

Cover



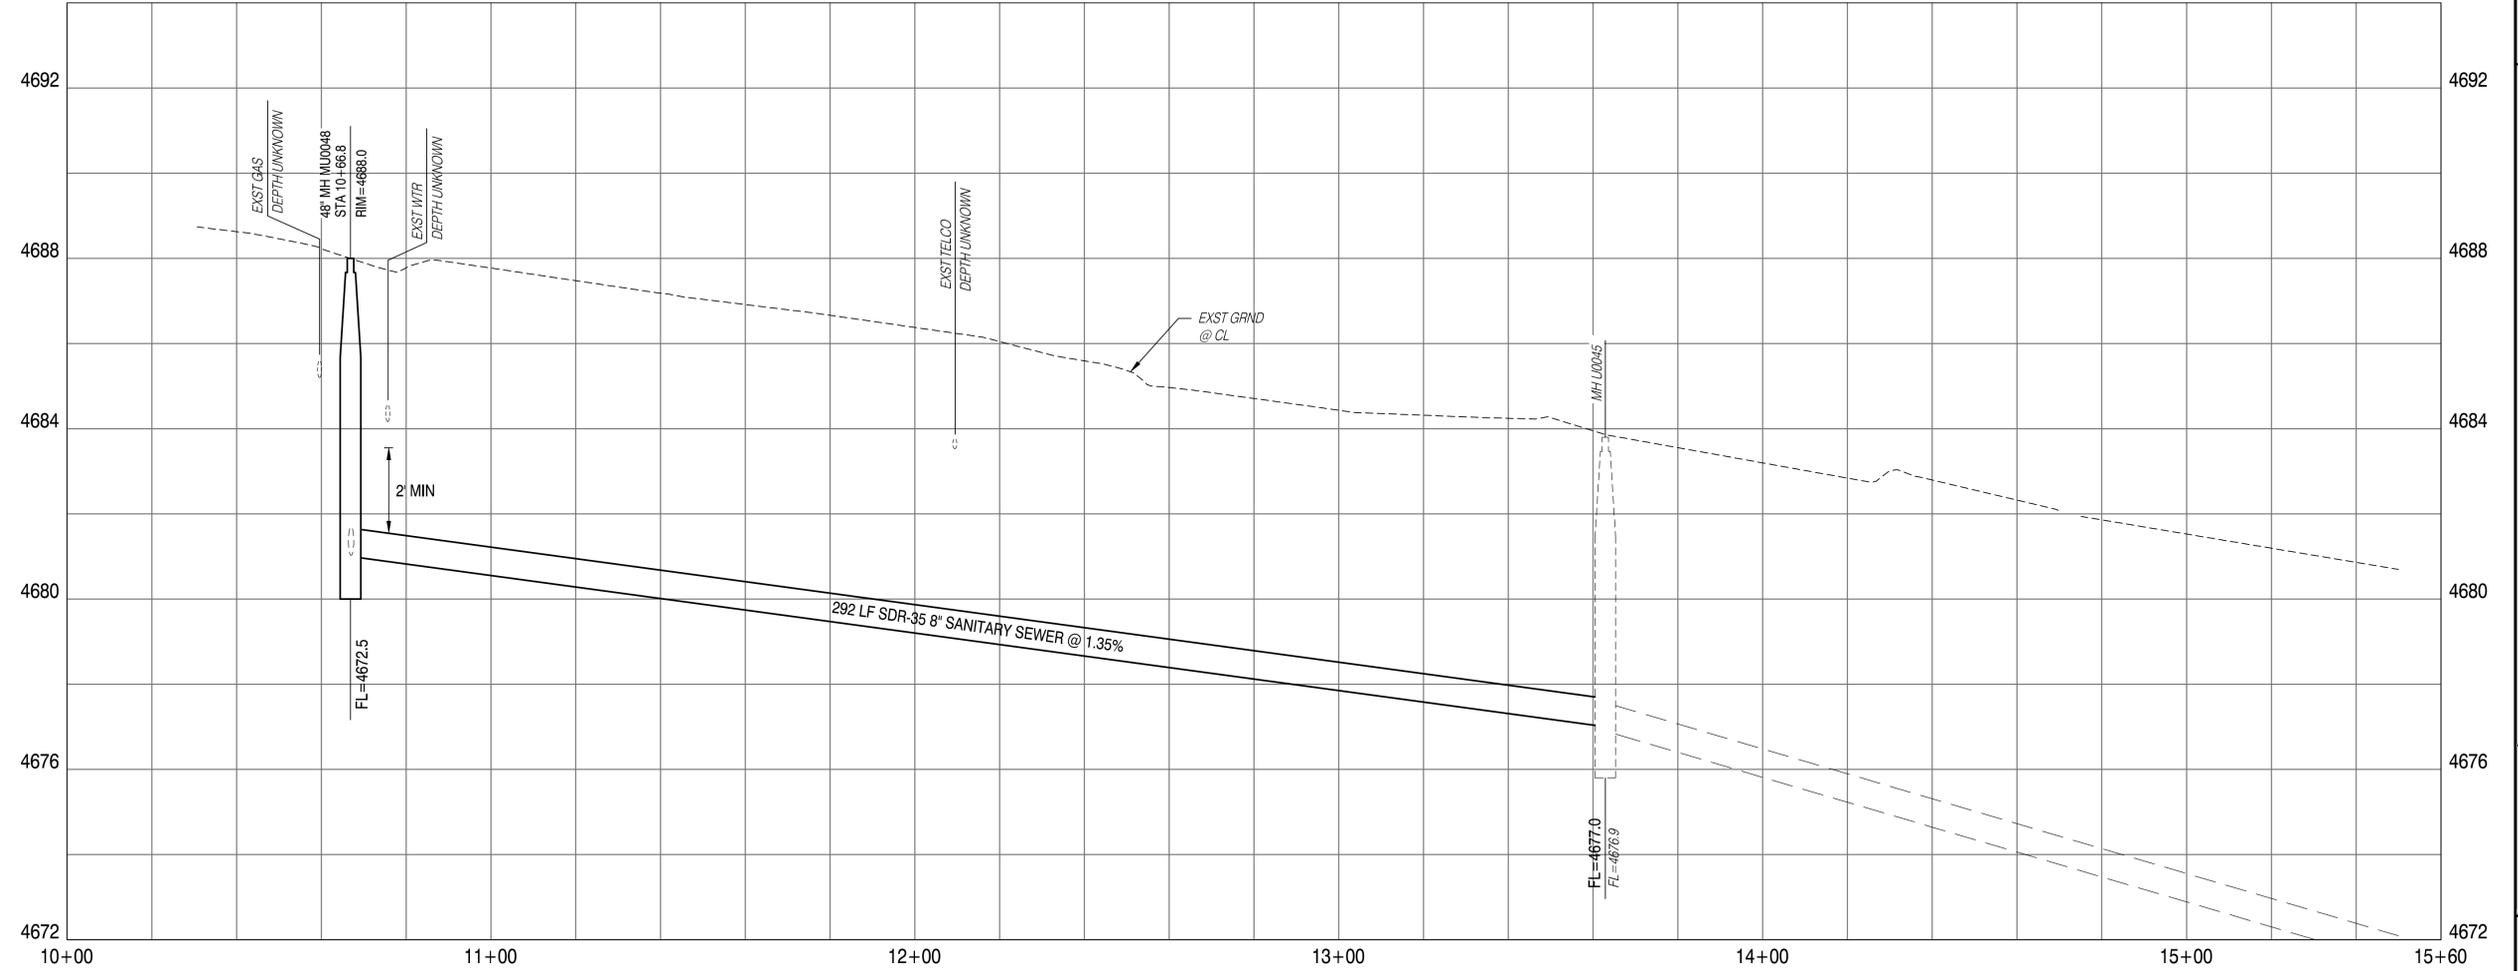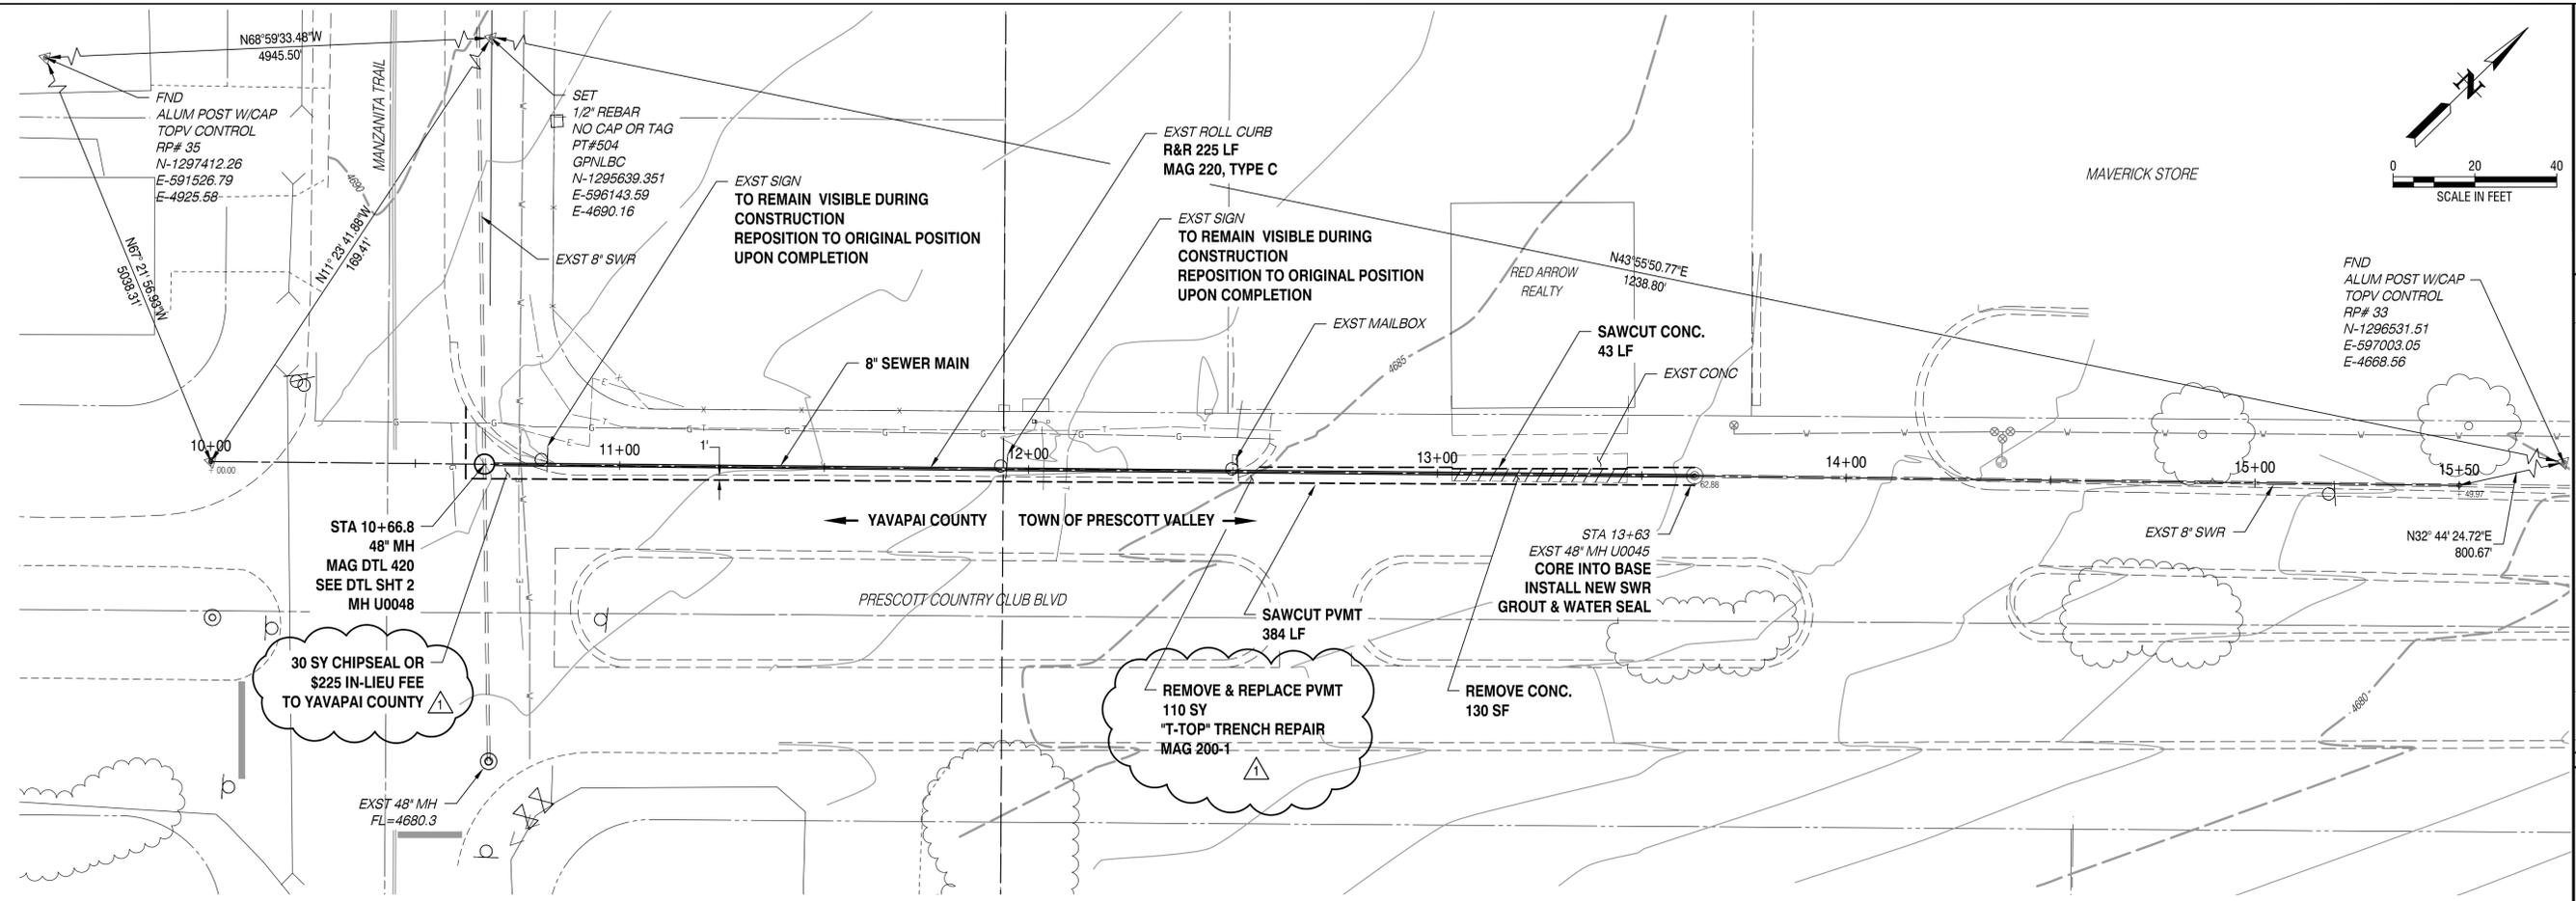

DAY & ASSOCIATES, INC.
 310 E. UNION STREET
 PRESCOTT, AZ 86303
 (928) 776-7587
 www.daycivil.com

PLANNING
 ENGINEERING
 SURVEYING

CHECKED BY: GMB
 DESIGNED BY: GHH

| NO. | DATE |
|-----|------|
| | |
| | |
| | |
| | |

PROJECT NO. **374scfd3**
 DATE **July 2013**

**SANITARY SEWER IMPROVEMENTS
 PRESCOTT COUNTRY CLUB BLVD**

Plan & Profile

SHEET NUMBER
3 OF 3