GENERAL NOTES

1. REFER TO WALL SCHEDULE A6.3 FOR ALL WALL TYPES.
2. ALL WALL TYPES AREA TYPE P1, UNLESS NOTED OTHERWISE.

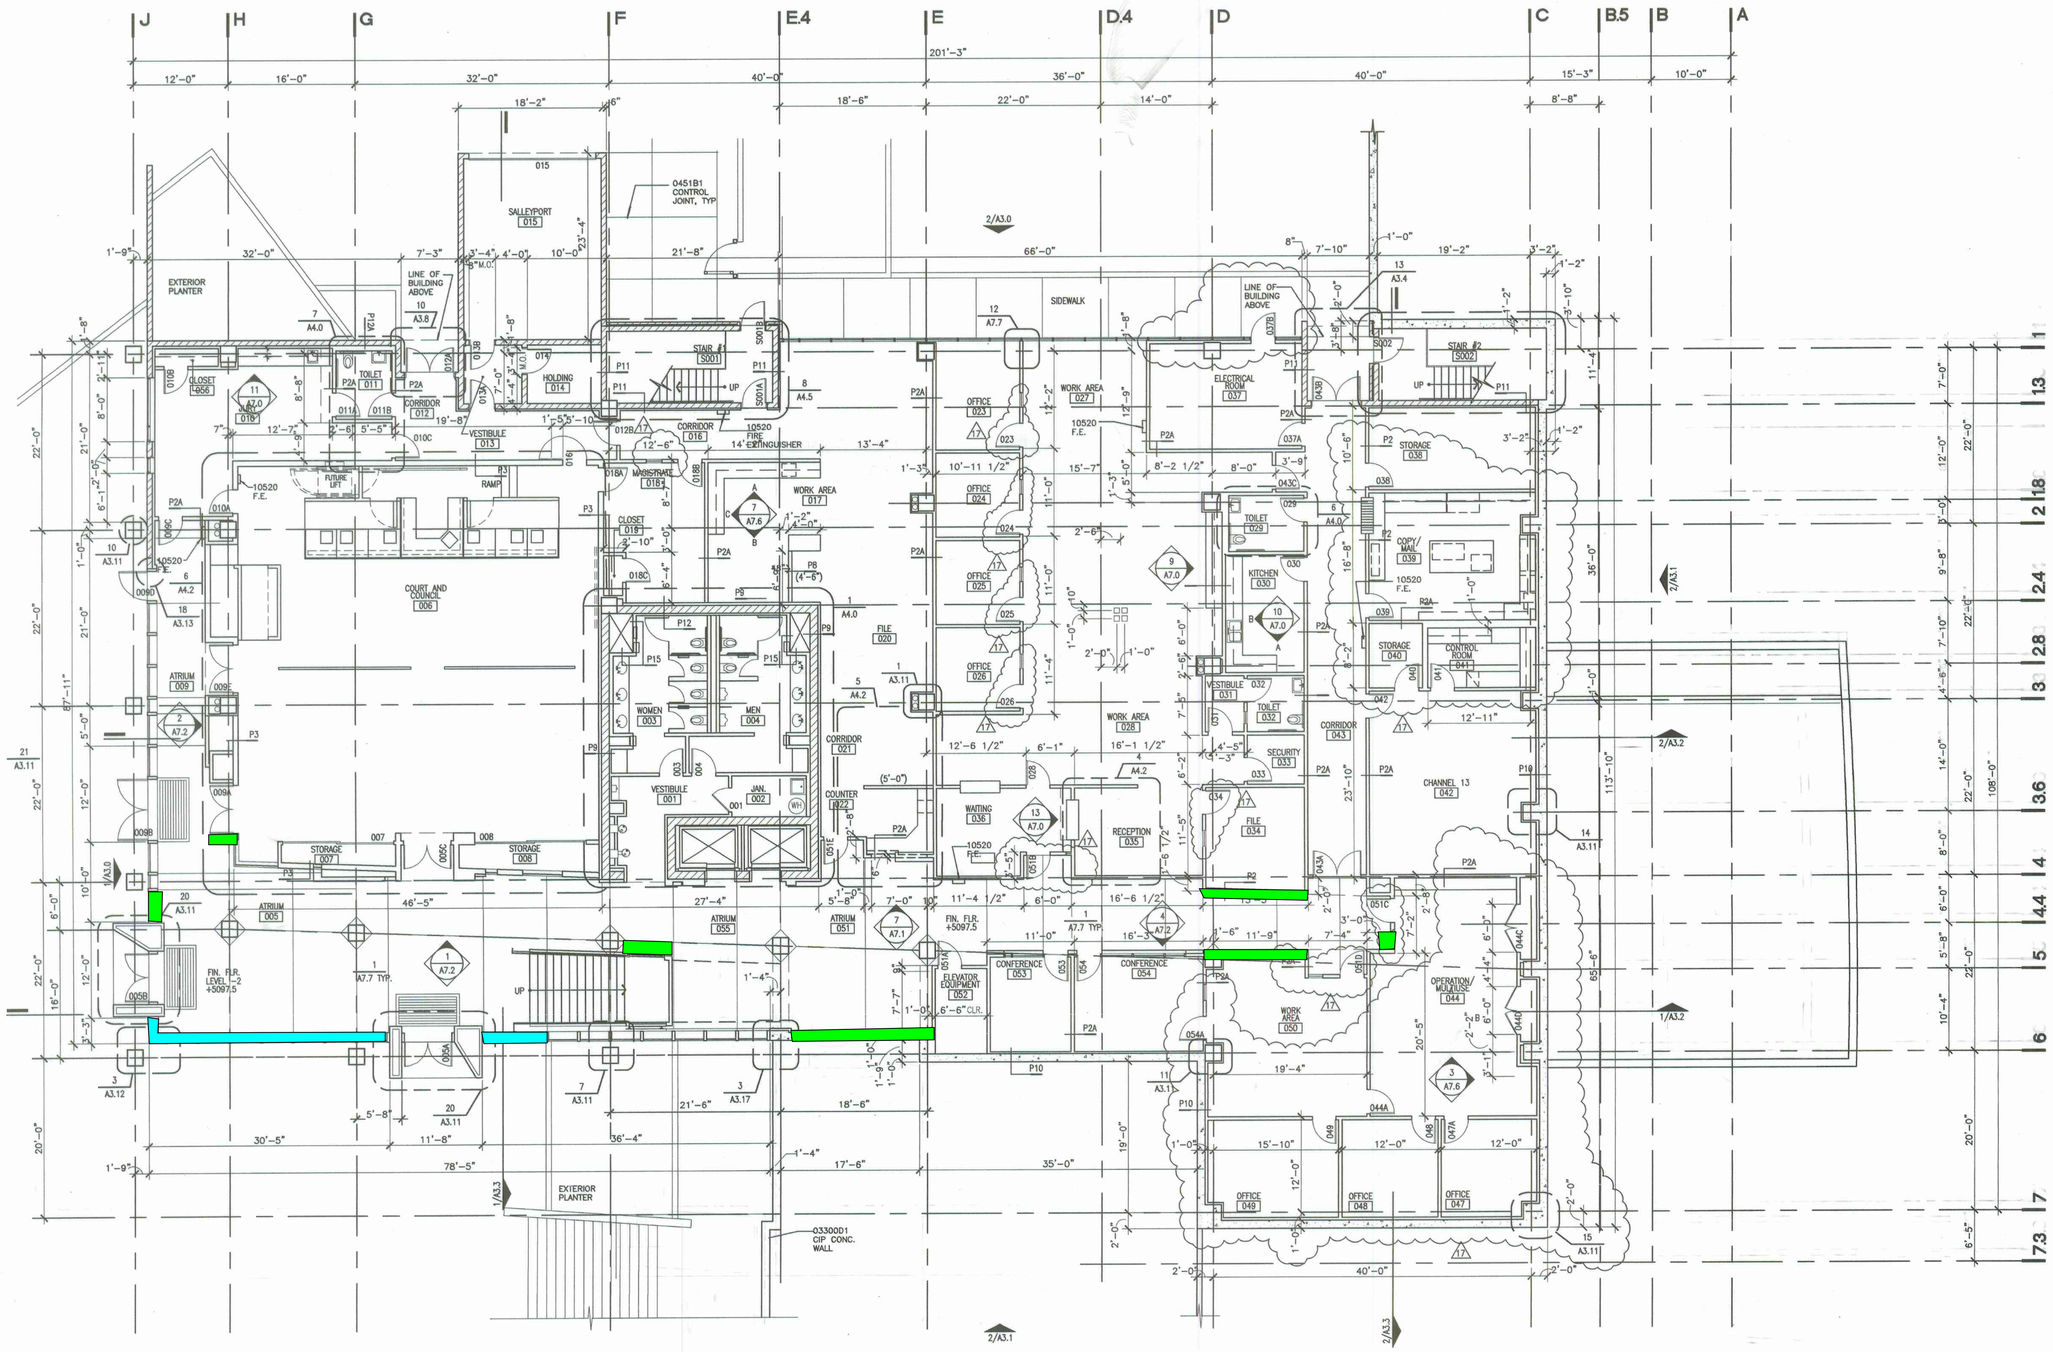

LANGDON WILSON

ARCHITECTURE
PLANNING
INTERIORS

455 NORTH THIRD STREET
SUITE 333
PHOENIX, ARIZONA 85004
602 252-2555

STRUCTURAL ENGINEER
PAUL-KOEHLER CONSULTING
STRUCTURAL ENGINEERS, INC
PHOENIX, ARIZONA

MECHANICAL / PLUMBING / ELECTRICAL ENGINEERS
PETERSON ASSOCIATES
PHOENIX, ARIZONA

CIVIL ENGINEER
KELLEY/WISE ENGINEERING, INC.
PRESCOTT, ARIZONA

LANDSCAPE ARCHITECT
E GROUP
PHOENIX, ARIZONA

PROJECT MANAGER
PROFESSIONAL REALTY AND CONSTRUCTION
PRESCOTT, ARIZONA

PRESCOTT Valley

TOWN HALL AND LIBRARY

TOWN OF PRESCOTT VALLEY
7501 CIVIC CIRCLE
PRESCOTT VALLEY, ARIZONA

RECORD DRAWINGS
JOE E. WOODS
As Agent for Federal Insurance Co.

CONSTRUCTION PHASE			PRE-CONSTRUCTION PHASE	
REV	BULLETIN	DATE	DATE	ISSUED FOR
1	BULLETIN NO. 1 CONSTRUCTION SET	10/01/97	04/02/97	DESIGN DEVELOPMENT
			05/16/97	50% CONSTRUCTION DOCUMENTS
	ASI 03	05/08/98		
2	BULLETIN NO. 17 CONSTRUCTION SET	8/19/98	06/10/97	75% CONSTRUCTION DOCUMENTS
			07/25/97	100% CONSTRUCTION DOCUMENTS
			08/20/97	BID SET
			08/29/97	2 ADDENDUM NO. 2

CHECKED BY :
DATE : 07/25/98
DRAWN
NUMBER : 9629-100
APPROVED/AR
SCALE : 1/8" = T
FILE: A2-OREV

SHEET TITLE :
FLOOR PLAN
LEVEL -2

SHEET NUMBER
A-2.0

PLOTTED: 10/01/97

06-09-127